

ADU PROGRAM

OWNER:
CITY OF FRESNO
PLANNING AND DEVELOPMENT DEPARTMENT
201 KOREAN AVENUE, SUITE 100
FRESNO, CA 93701

ARCHITECT:
AARON NEUBERT ARCHITECTS, INC.
204 KOREAN AVENUE, SUITE 100
FRESNO, CA 93701

STRUCTURAL ENGINEER:
NOUS ENGINEERING, INC.
101 PINEWOOD PLACE
LOS ANGELES, CALIFORNIA 90045

MEP ENGINEERS:
INNOV8 DESIGN AND ENGINEERING
701 PINEWOOD PLACE
LOS ANGELES, CALIFORNIA 90045

REVIEWER: DATE: COMMENTS:

ISSUE:
△ REVISION #2 06.03.22 PLAN CHECK CORRECTIONS
△ REVISION #1 04.04.22 PLAN CHECK CORRECTIONS

SEAL:







Proj# 2104
ADU PROGRAM
CITY OF FRESNO
CALIFORNIA

DRAWING TITLE:
ADU 01 - CRAFTSMAN
ELEVATIONS
SECTIONS

DATE: JUNE 3, 2022
SCALE: 1/4"=1'-0"
DRAWN BY:

A.200c

© Aaron Neubert Architects, Inc. 2022

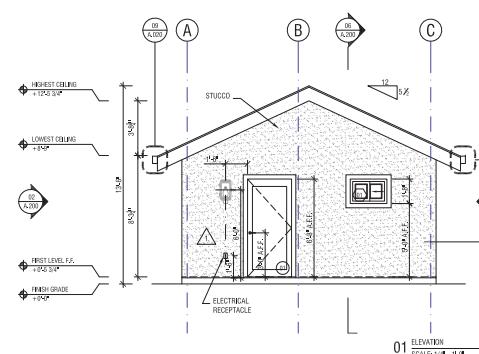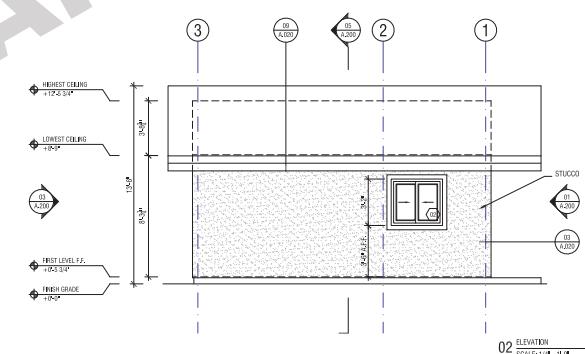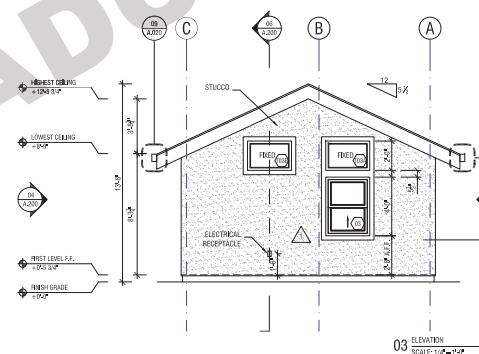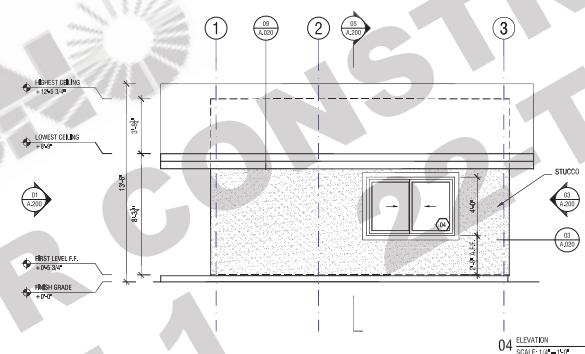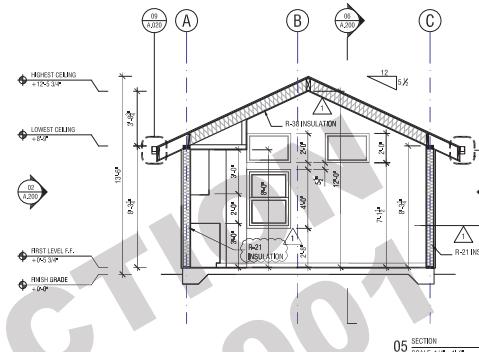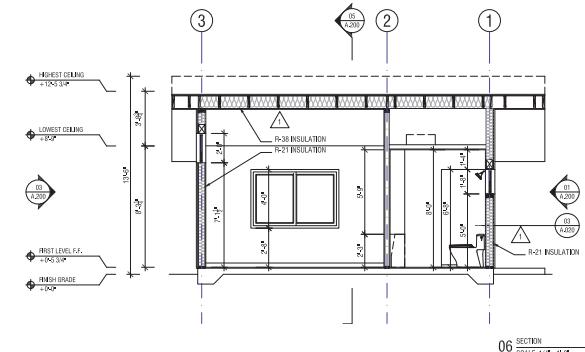

ADU PROGRAM

OWNER:

CITY OF FRESNO
PLANNING AND DEVELOPMENT DEPARTMENT
201 N. KOREAN AVENUE, SUITE 100
FRESNO, CA 93701

ARCHITECT:

AARON NEUBERT ARCHITECTS, INC.
201 N. KOREAN AVENUE, SUITE 100
FRESNO, CA 93701
AARON NEUBERT, SAN JACINTO

STRUCTURAL ENGINEER:

NOUS ENGINEERING, INC.
201 N. KOREAN AVENUE, SUITE 100
FRESNO, CA 93701
PLATZ & PARTNERS

MEP ENGINEER:

INNOV8 DESIGN AND ENGINEERING
701 PINEBROOK PLACE
FRESNO, CA 93720
PLATZ & PARTNERSINNOV8 DESIGN AND ENGINEERING
701 PINEBROOK PLACE
FRESNO, CA 93720
PLATZ & PARTNERS

REVISION DATE COMMENTS

- REVISION #2 06/03/22 PLAN CHECK CORRECTIONS
- REVISION #1 04/04/22 PLAN CHECK CORRECTIONS

SEAL:

Project No. 2104
ADU PROGRAM
CITY OF FRESNO
CALIFORNIADrawing Title:
ADU 01 - GABLE
ELEVATIONS
SECTIONS







DATE: JUNE 3, 2022

SCALE: 1/4"=1'-0"

DRAWN BY:

A.200g

© Aaron Neubert Architects, Inc. 2022

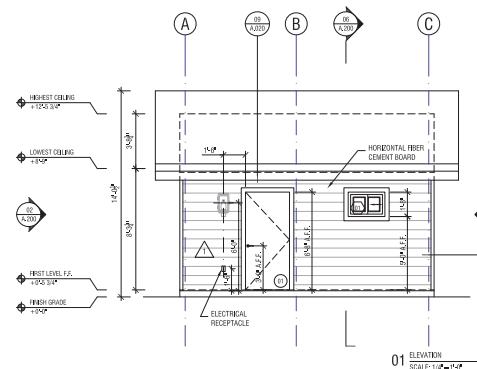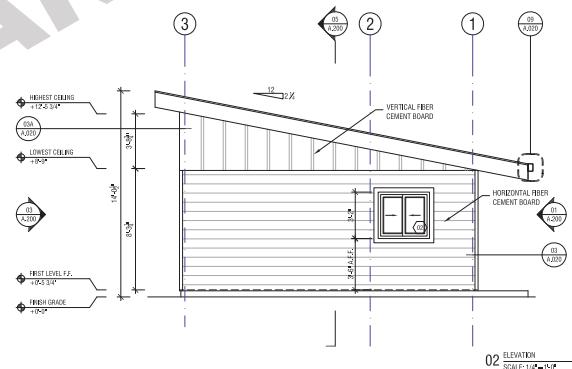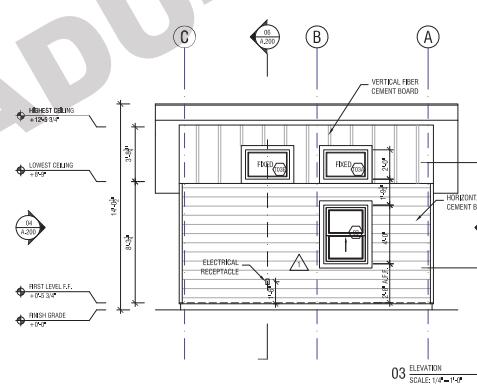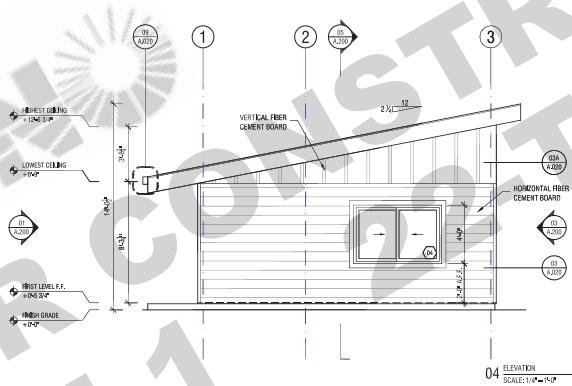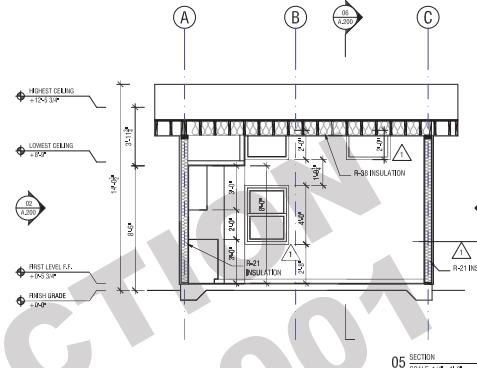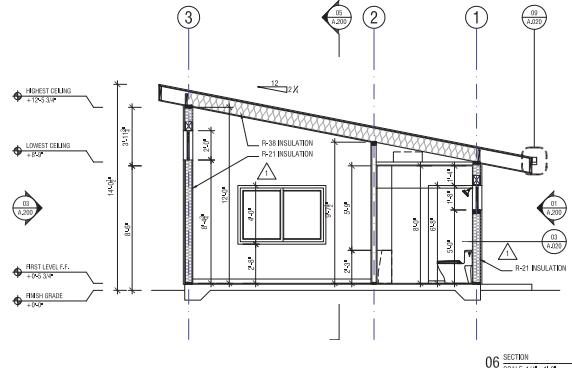

ADU PROGRAM

OWNER:
CITY OF FRESNO
PLANNING AND DEVELOPMENT DEPARTMENT
201 KOREAN AVENUE, SUITE 100
FRESNO, CA 93701

ARCHITECT:
AARON NEUBERT ARCHITECTS, INC.
201 KOREAN AVENUE, SUITE 100
FRESNO, CA 93701
AARON NEUBERT, SAN GABRIEL

STRUCTURAL ENGINEER:
NOUS ENGINEERING, INC.
1000 KOREAN AVENUE, SUITE 100
FRESNO, CA 93701

MEP ENGINEERS:
INNOV8 DESIGN AND ENGINEERING
701 PINEBROOK PLACE
FRESNO, CA 93727
F-204-1207

REVISION DATE COMMENTS

ISSUE
△ REVISION #2 06/03/22 PLAN CHECK CORRECTIONS
△ REVISION #1 04/04/22 PLAN CHECK CORRECTIONS



PROJ. NO. 2104
ADU PROGRAM
CITY OF FRESNO
CALIFORNIA

DRAWING TITLE
ADU 01 - CONTEMPORARY
ELEVATIONS
SECTIONS

DATE: JUNE 3, 2022
SCALE: 1/4"=1'-0"
DRAWN BY:

A.200s

© Aaron Neubert Architects, Inc. 2022