

## ADU PROGRAM

OWNER:  
CITY OF FRESNO  
PLANNING AND DEVELOPMENT DEPARTMENT  
201 KIRKWOOD AVENUE, SUITE 100  
FRESNO, CA 93701

ARCHITECT:  
AARON NEUBERT ARCHITECTS, INC.  
201 KIRKWOOD AVENUE, SUITE 100  
FRESNO, CA 93701  
AARON NEUBERT SAN DIEGO

STRUCTURAL ENGINEER:  
NOUS ENGINEERING, INC.  
701 PINEBROOK PLACE  
FRESNO, CALIFORNIA 93727  
P-2014-12007

MEP ENGINEERS:  
INNOV8 DESIGN AND ENGINEERING  
701 PINEBROOK PLACE  
FRESNO, CALIFORNIA 93727  
P-2014-12007

REVISION DATE: COMMENTS:  
△ REVISION #2-0603.22 PLAN CHECK CORRECTIONS  
△ REVISION #1-0404.22 PLAN CHECK CORRECTIONS









Project No. 2104  
ADU PROGRAM  
CITY OF FRESNO  
CALIFORNIA

DRAWING TITLE:  
ADU 02 - CRAFTSMAN  
ELEVATIONS  
SECTIONS

DATE: JUNE 3, 2022  
SCALE: 1/8" = 1'-0"  
DRAWN BY:

A.200c

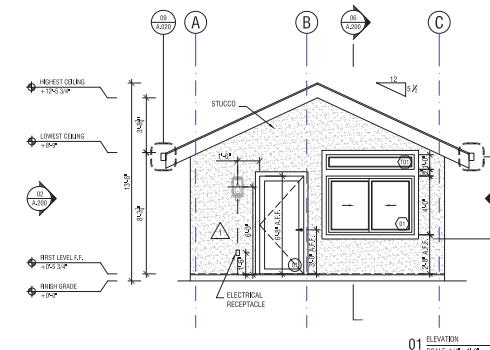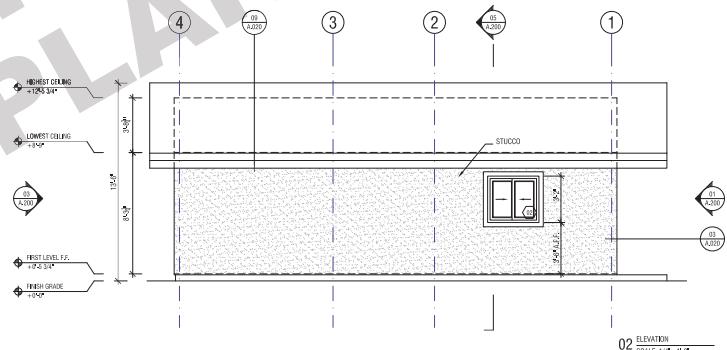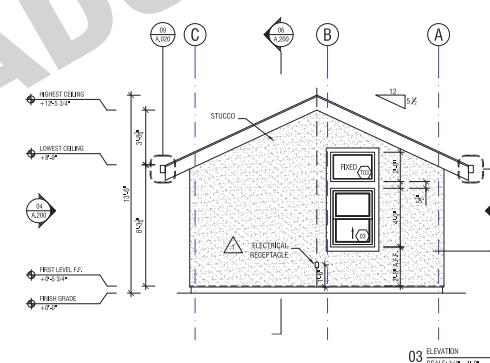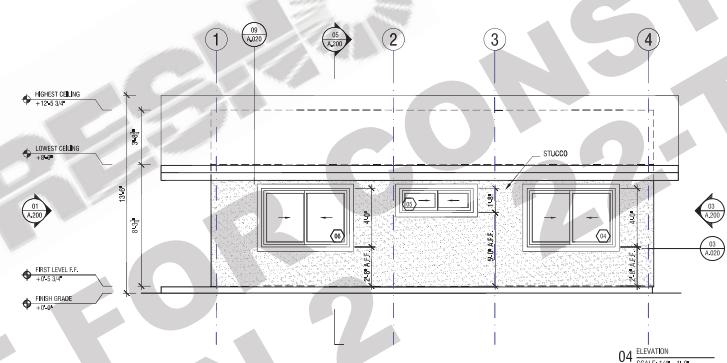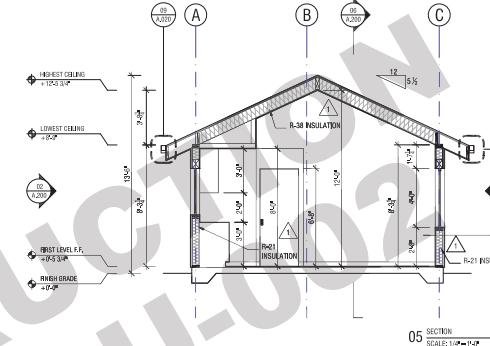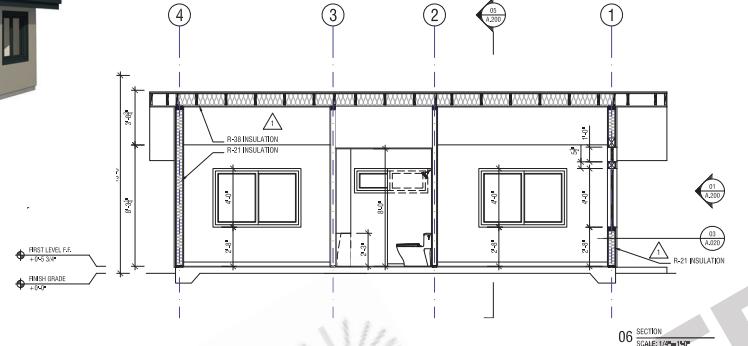

## ADU PROGRAM

OWNER:  
CITY OF FRESNO  
PLANNING AND DEVELOPMENT DEPARTMENT  
201 KIRKWOOD AVENUE, SUITE 100  
FRESNO, CA 93701

ARCHITECT:  
AARON NEUBERT ARCHITECTS, INC.  
201 KIRKWOOD AVENUE, SUITE 100  
FRESNO, CA 93701  
AARON NEUBERT SAN DIEGO

STRUCTURAL ENGINEER:  
NOUS ENGINEERING, INC.  
701 POMONA PLACE  
FRESNO, CALIFORNIA 93704  
P-2014-12007

MEP ENGINEERS:  
INNOV8 DESIGN AND ENGINEERING  
701 POMONA PLACE  
FRESNO, CALIFORNIA 93704  
P-2014-12007

REVISION DATE COMMENTS  
02 REVISION #2 06/03/22 PLAN CHECK CORRECTIONS  
01 REVISION #1 04/04/22 PLAN CHECK CORRECTIONS




Project No. 2104  
ADU PROGRAM  
CITY OF FRESNO  
CALIFORNIA

DRAWING TITLE:  
ADU 02 - GABLE  
ELEVATIONS  
SECTIONS

DATE: JUNE 3, 2022  
SCALE: 1/8"=1'-0"  
DRAWN BY:

A.200g

© Aaron Neubert Architects, Inc. 2022

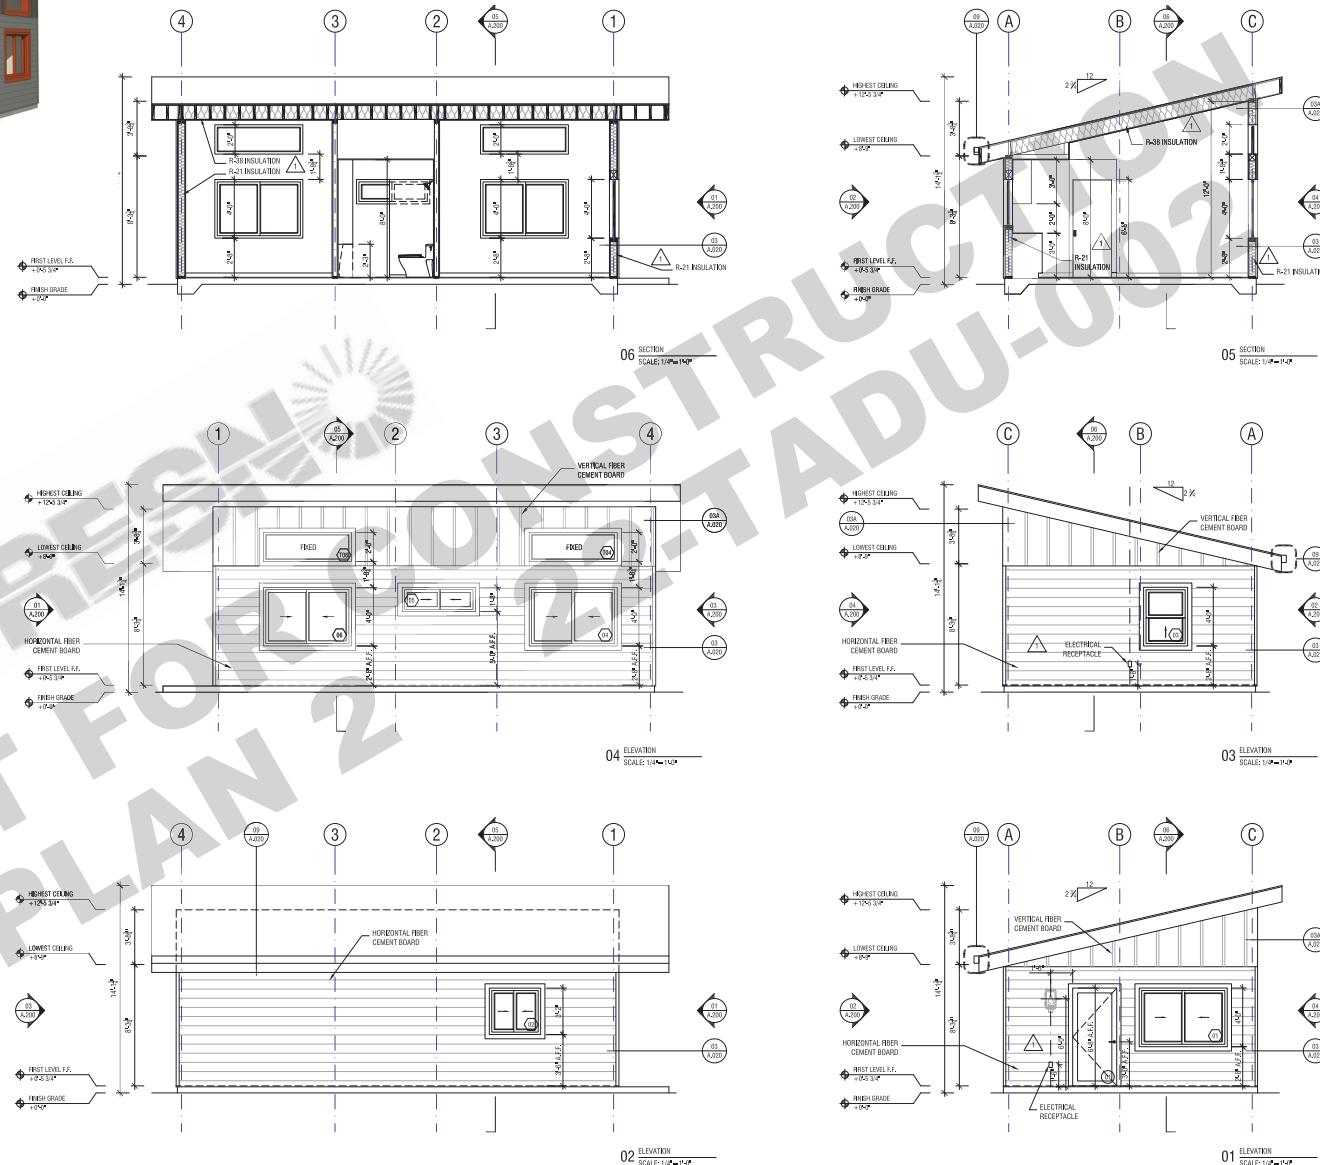

## ADU PROGRAM

OWNER:

CITY OF FRESNO  
PLANNING AND DEVELOPMENT DEPARTMENT  
201 KOREAN AVENUE, SUITE 100  
FRESNO, CA 93701

ARCHITECT:

AARON NEUBERT ARCHITECTS, INC.  
201 KOREAN AVENUE, SUITE 100  
FRESNO, CA 93701  
AARON NEUBERT, SAN JOSE

STRUCTURAL ENGINEER:

NOUS ENGINEERING, INC.  
1001 PINEWOOD PLACE  
LOS ANGELES, CALIFORNIA 90045  
PLATINUM MEMBER

MEP ENGINEERS:

INNOV8 DESIGN AND ENGINEERING  
701 PINEWOOD PLACE  
LOS ANGELES, CALIFORNIA 90045  
PLATINUM MEMBER

REVISION:

DATE: COMMENTS:

ISSUE:

REVISION #2: JUN 03, 2022 PLAN CHECK CORRECTIONS

ISSUE:

REVISION #1: APR 04, 2022 PLAN CHECK CORRECTIONS

Project No. 2104  
ADU PROGRAM  
CITY OF FRESNO  
CALIFORNIADRAWING TITLE:  
ADU 02 - CONTEMPORARY  
ELEVATIONS  
SECTIONS

DATE: JUNE 3, 2022

SCALE: 1/4=1'-0"

DRAWN BY:

A.200s

© Aaron Neubert Architects, Inc. 2022