







ADU PROGRAM

OWNER:
CITY OF FRESNO
PLANNING AND DEVELOPMENT DEPARTMENT
201 RIVERFRONT AVENUE, SUITE 100
FRESNO, CA 93701

ARCHITECT:
AARON NEUBERT ARCHITECTS, INC.
201 RIVERFRONT AVENUE, SUITE 100
FRESNO, CA 93701
AARON NEUBERT, SAN CARLOS

STRUCTURAL ENGINEER:
NOUS ENGINEERING, INC.
1000 EAGLE ROCK BLVD., SUITE 100
LOS ANGELES, CALIFORNIA 90041

MEP ENGINEERS:
INNOV8 DESIGN AND ENGINEERING
701 PINEBROOK PLACE
FRESNO, CALIFORNIA 93726
P-2024-1207

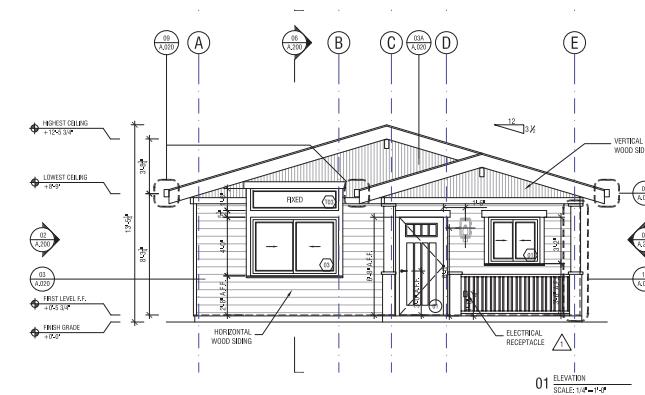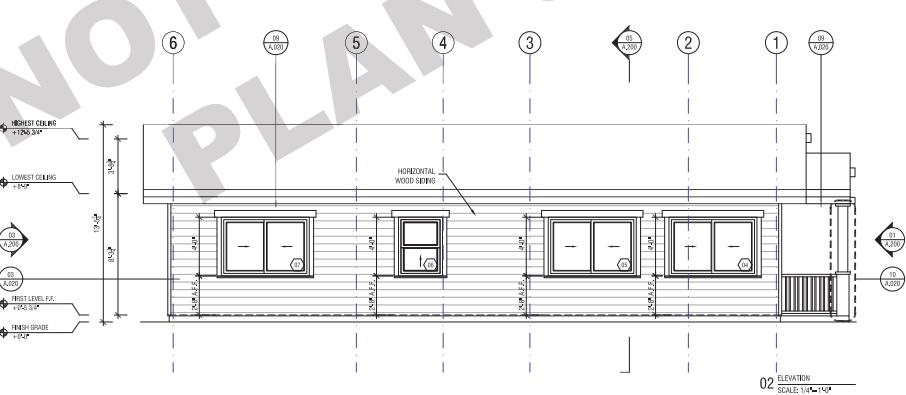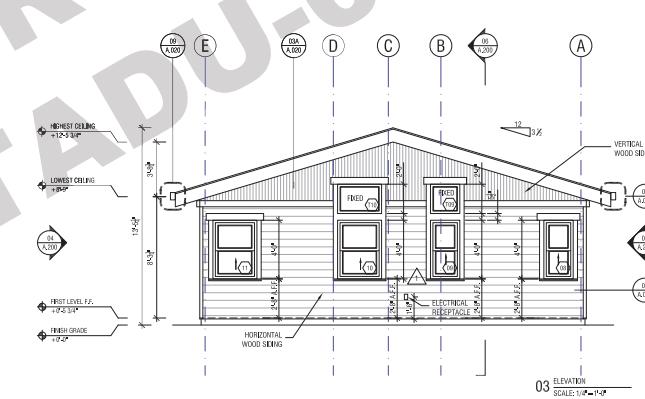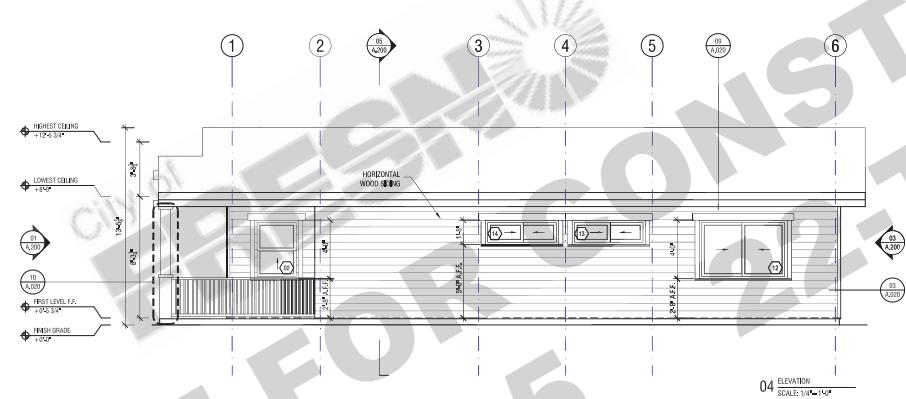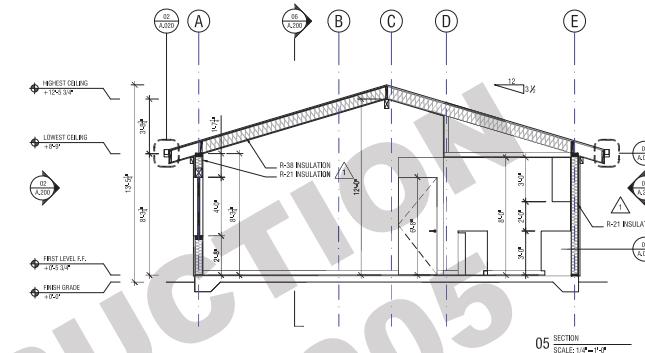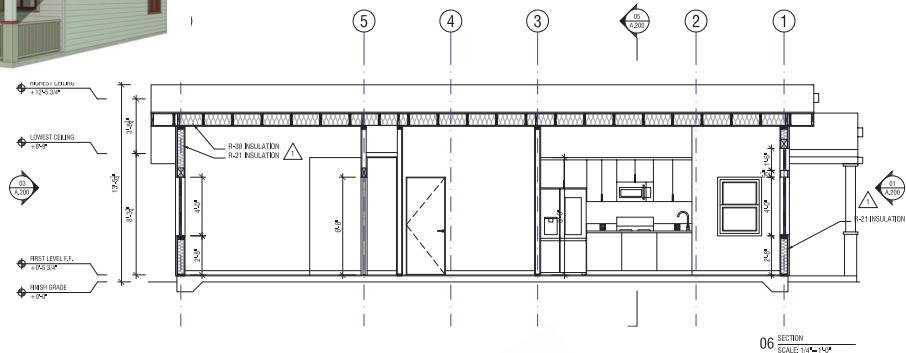

REVISION DATE: COMMENTS:
△ REVISION #2 06/03/22 PLAN CHECK CORRECTIONS
△ REVISION #1 04/04/22 PLAN CHECK CORRECTIONS



Project No. 2104
ADU PROGRAM
CITY OF FRESNO
CALIFORNIA

DRAWING TITLE:
ADU 05 - CRAFTSMAN
ELEVATIONS
SECTIONS

DATE: JUNE 3, 2022
SCALE: 1/4" = 1'-0"
DRAWN BY:

A.200c

ADU PROGRAM

OWNER

CITY OF FRESNO
PLANNING AND DEVELOPMENT DEPARTMENT
1011 FRESNO AVENUE, 4TH FLOOR
FRESNO, CA 93701

ARCHITECTS

AARON NEUBERT ARCHITECTS, INC.
1011 FRESNO AVENUE, 4TH FLOOR
FRESNO, CA 93701
AARON NEUBERT CFA #0406

STRUCTURAL ENGINEER

NOUS ENGINEERING, INC.
1011 FRESNO AVENUE, 4TH FLOOR
FRESNO, CA 93701
P.C. #0414-0005

MEP ENGINEER

INNODEZ DESIGN AND ENGINEERING
707 FORESTHILL DRIVE
LOS MIGOS, CALIFORNIA 93755
P.C. #0414-0005

REVISION DATE COMMENT

ISSUE

2 REVISION #2 06.03.22 PLAN CHECK CORRECTIONS
1 REVISION #1 04.04.22 PLAN CHECK CORRECTIONS

SEAL









Project No. 2104
ADU PROGRAM
CITY OF FRESNO, CALIFORNIA







DRAWING TITLE
ADU 05 - GABLE ELEVATIONS SECTIONS

DATE JUNE 3, 2022
SCALE 1/4=1'-0"
DRAWN BY

© Aaron Neubert Architects, Inc. 2022

A.200g

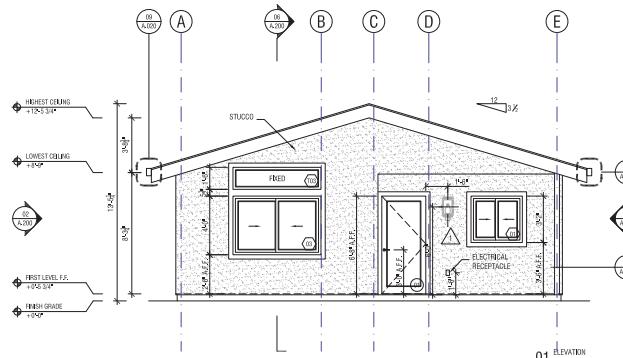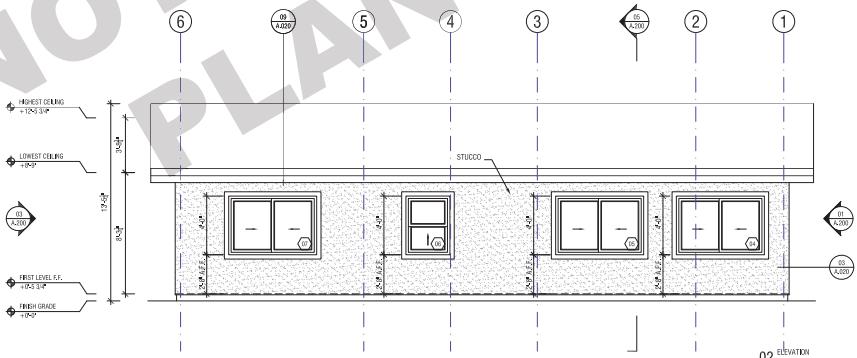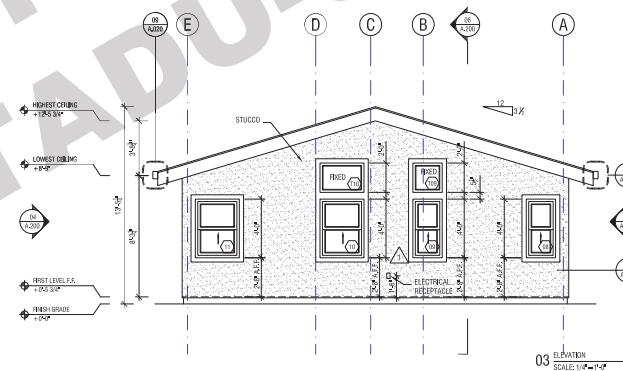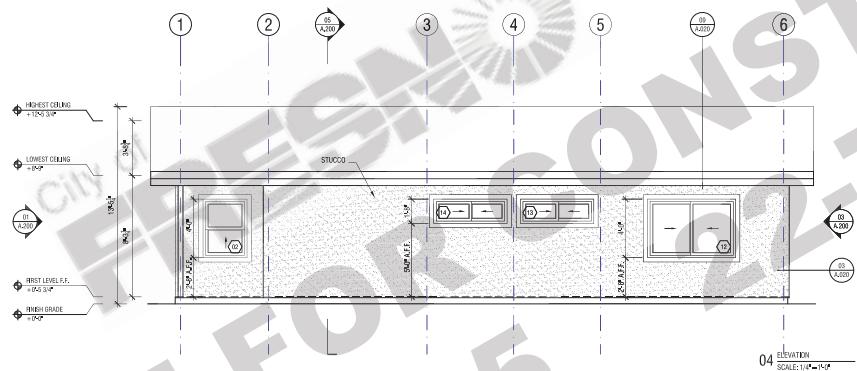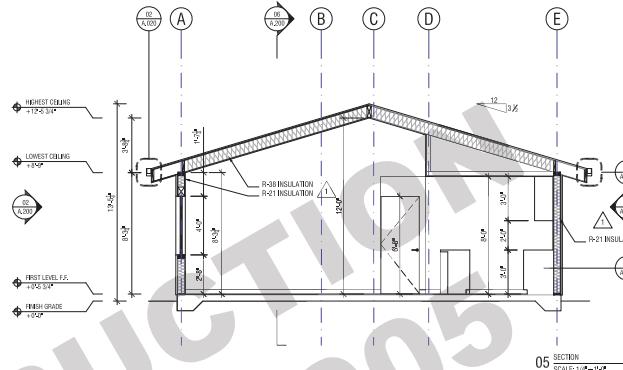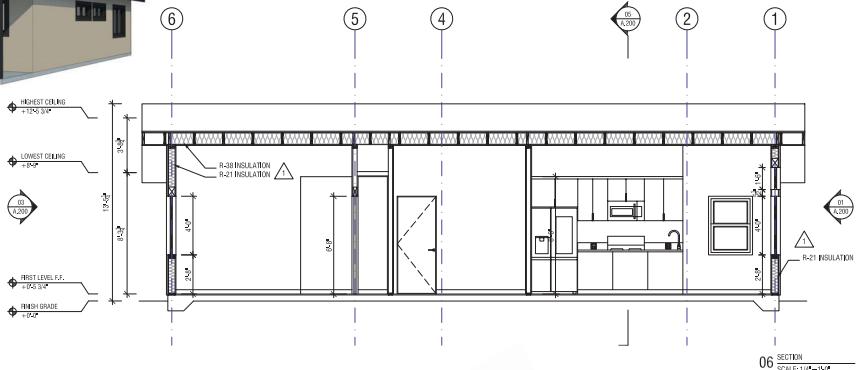

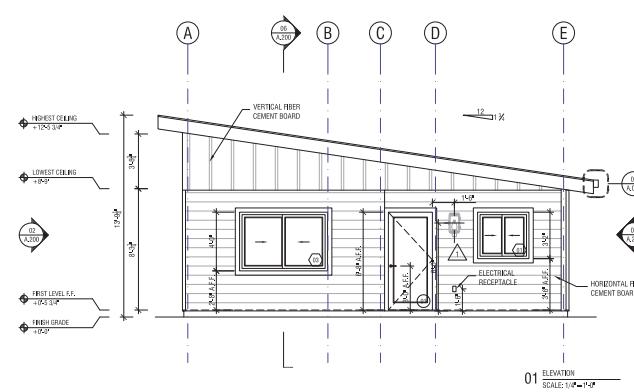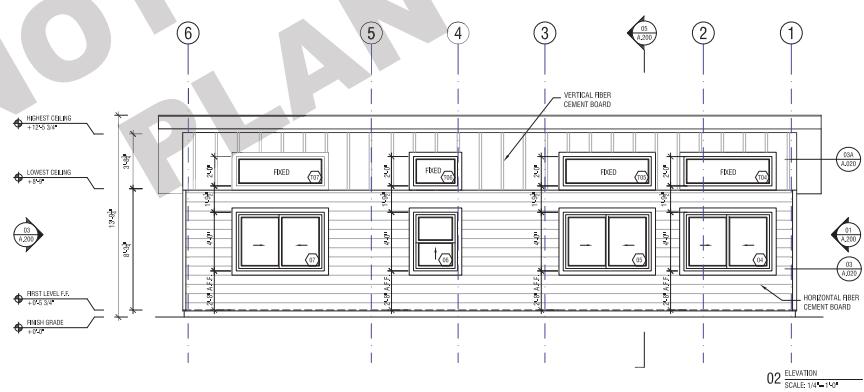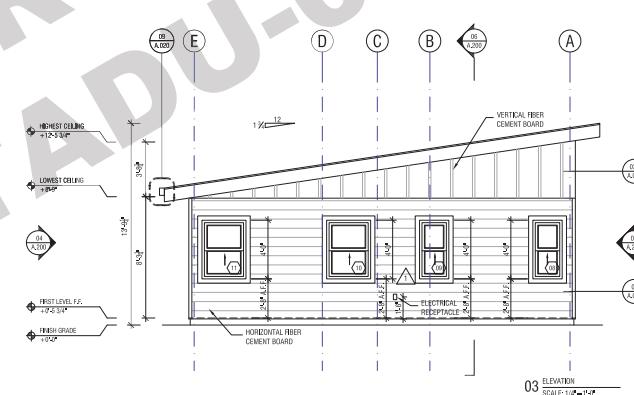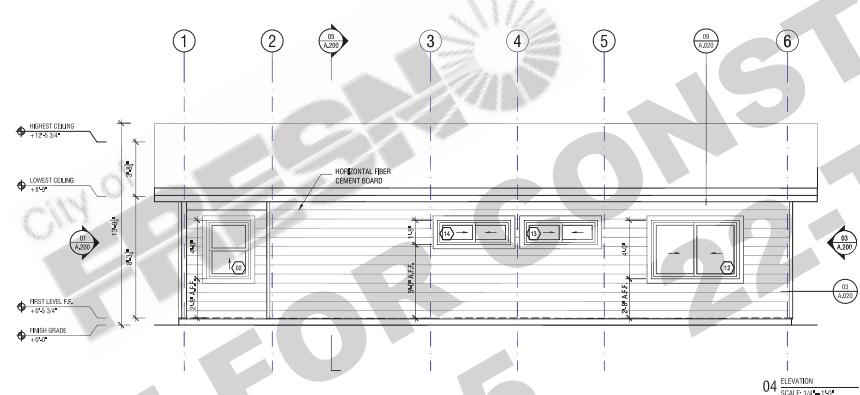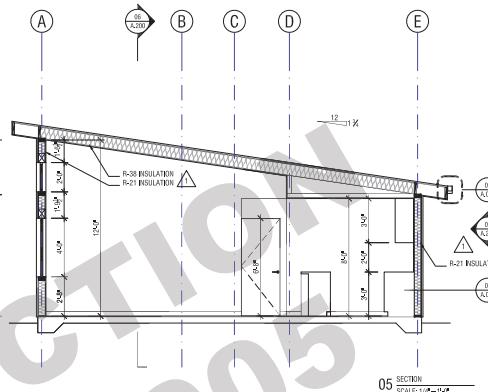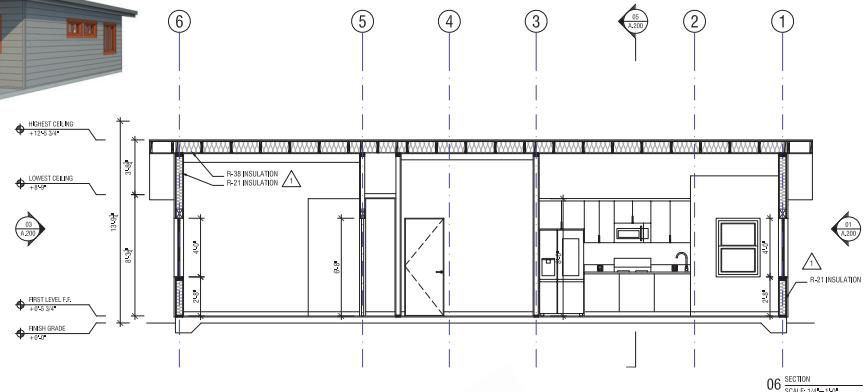

ADU PROGRAM

OWNER:
CITY OF FRESNO
PLANNING AND DEVELOPMENT DEPARTMENT
201 KINGS AVENUE, SUITE 100
FRESNO, CA 93701

ARCHITECT:
AARON NEUBERT ARCHITECTS, INC.
201 KINGS AVENUE, SUITE 100
FRESNO, CA 93701

STRUCTURAL ENGINEER:
NOUS ENGINEERING, INC.
100 PINEWOOD PLACE
LOS ANGELES, CALIFORNIA 90045

MEP ENGINEERS:
INNOV8 DESIGN AND ENGINEERING
701 PINEWOOD PLACE
LOS ANGELES, CALIFORNIA 90045

REVISIONS DATE COMMENTS

ISSUE □ REVISION #2 06/03/22 PLAN CHECK CORRECTIONS

ISSUE □ REVISION #1 04/04/22 PLAN CHECK CORRECTIONS



Proj. No. 2104
ADU PROGRAM
CITY OF FRESNO
CALIFORNIA

DRAWING TITLE
ADU 05 - CONTEMPORARY
ELEVATIONS
SECTIONS

DATE: JUNE 3, 2022
SCALE: 1/4" = 1'-0"
DRAWN BY:

A.200s

© Aaron Neubert Architects, Inc. 2022